

REEL NO: 812033-01
 SIZE: 144 FO LEAF
 MFG: FUJIKURA



ASSEMBLY UNITS				ASSEMBLY UNITS				ASSEMBLY UNITS				REVISION			
UNIT	QUANTITY	ACCT. CODE	DESCRIPTION	UNIT	QUANTITY	ACCT. CODE	DESCRIPTION	UNIT	QUANTITY	ACCT. CODE	DESCRIPTION	REV	DESCRIPTION	DATE	BY
412	167'	820	S/LOOP 144 FO												
410	886'	820	PULL 144 FO LEAF												
250	2	826	HH												

TIME WARNER
TELECOM

AS-BUILT
MADERA REGEN
TO FRESNO HUB

KEYMAP REFERENCE



Sheet No: 433 of 506

042R433A

433 of 506


0-3/20 --

0-3/20 --

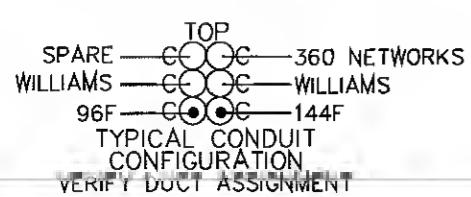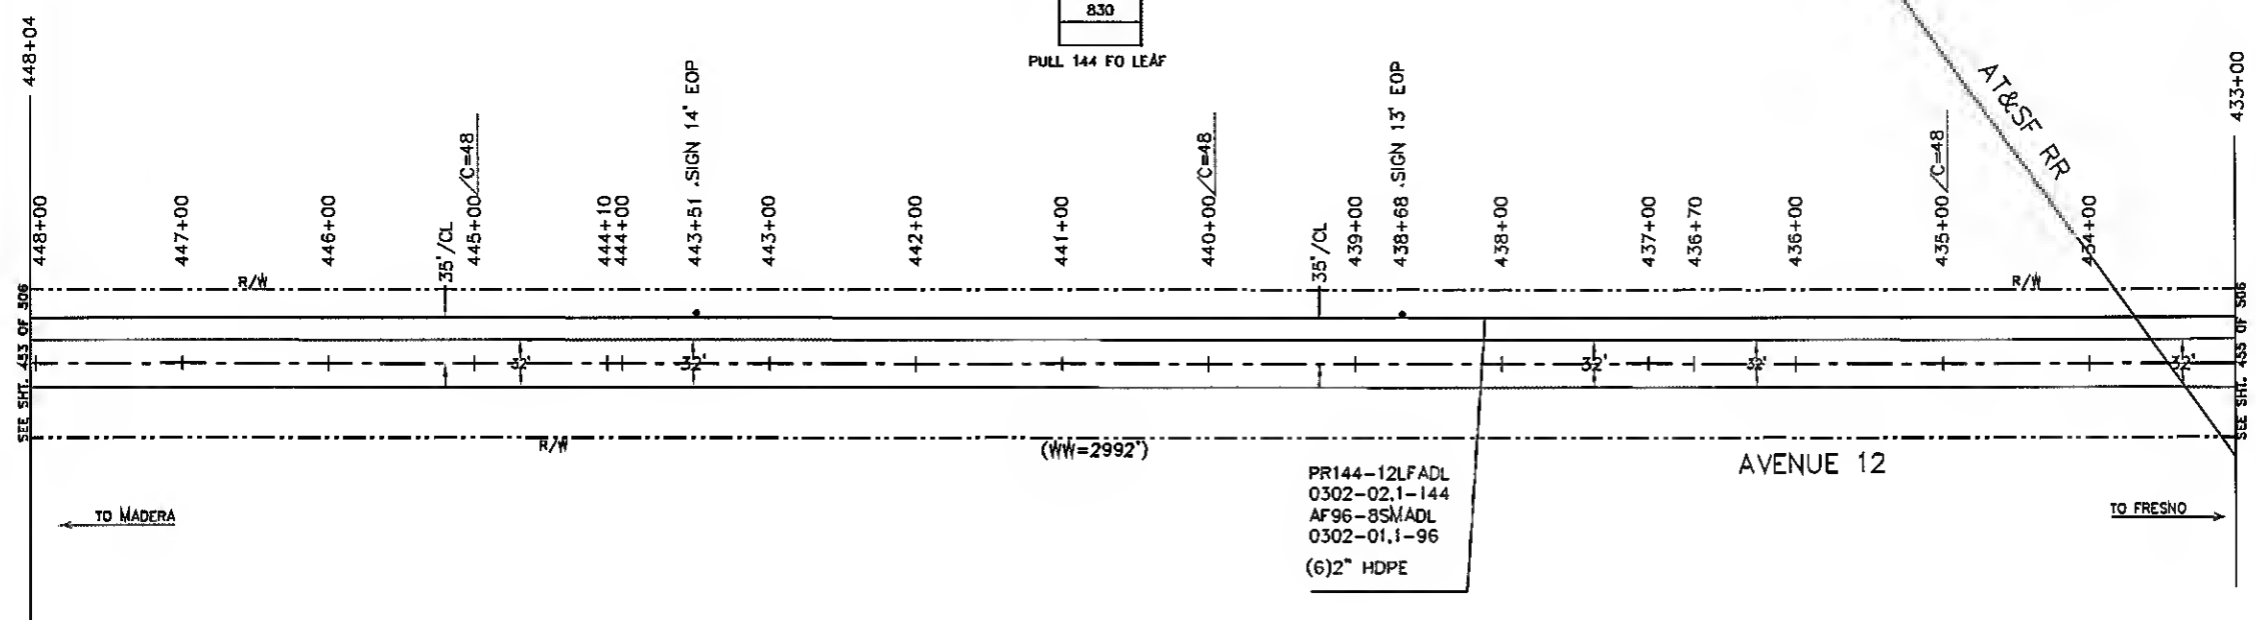

PR144-12LFADL
0302-02.1-144
AF96-8SMADL
0302-01.1-96
(6)2" HDPE

REEL NO: 812019-01
SIZE: 144 FO LEAF
MFG: FUJIKURA

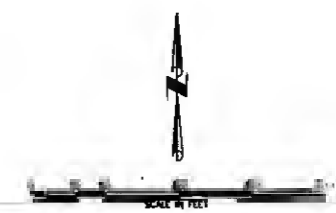

ASSEMBLY UNITS				ASSEMBLY UNITS				ASSEMBLY UNITS				REVISION			
UNIT	QUANTITY	ACCT. CODE	DESCRIPTION	UNIT	QUANTITY	ACCT. CODE	DESCRIPTION	UNIT	QUANTITY	ACCT. CODE	DESCRIPTION	REV	DESCRIPTION	DATE	BY
410	1529'	820	PULL 144 FO LEAF												

**AS-BUILT
MADERA REGEN
TO FRESNO HUB**

KEYMAP REFERENCE

DRAWN BY	
DATE	
REVIEWED BY	
DATE	
REVISION	
DRAWING NUMBER	
042R454A	
ENC	OF
454	506
SCALE	
B-920	--
D-920	--

